


CONNECTS TO SHEET NO. 13

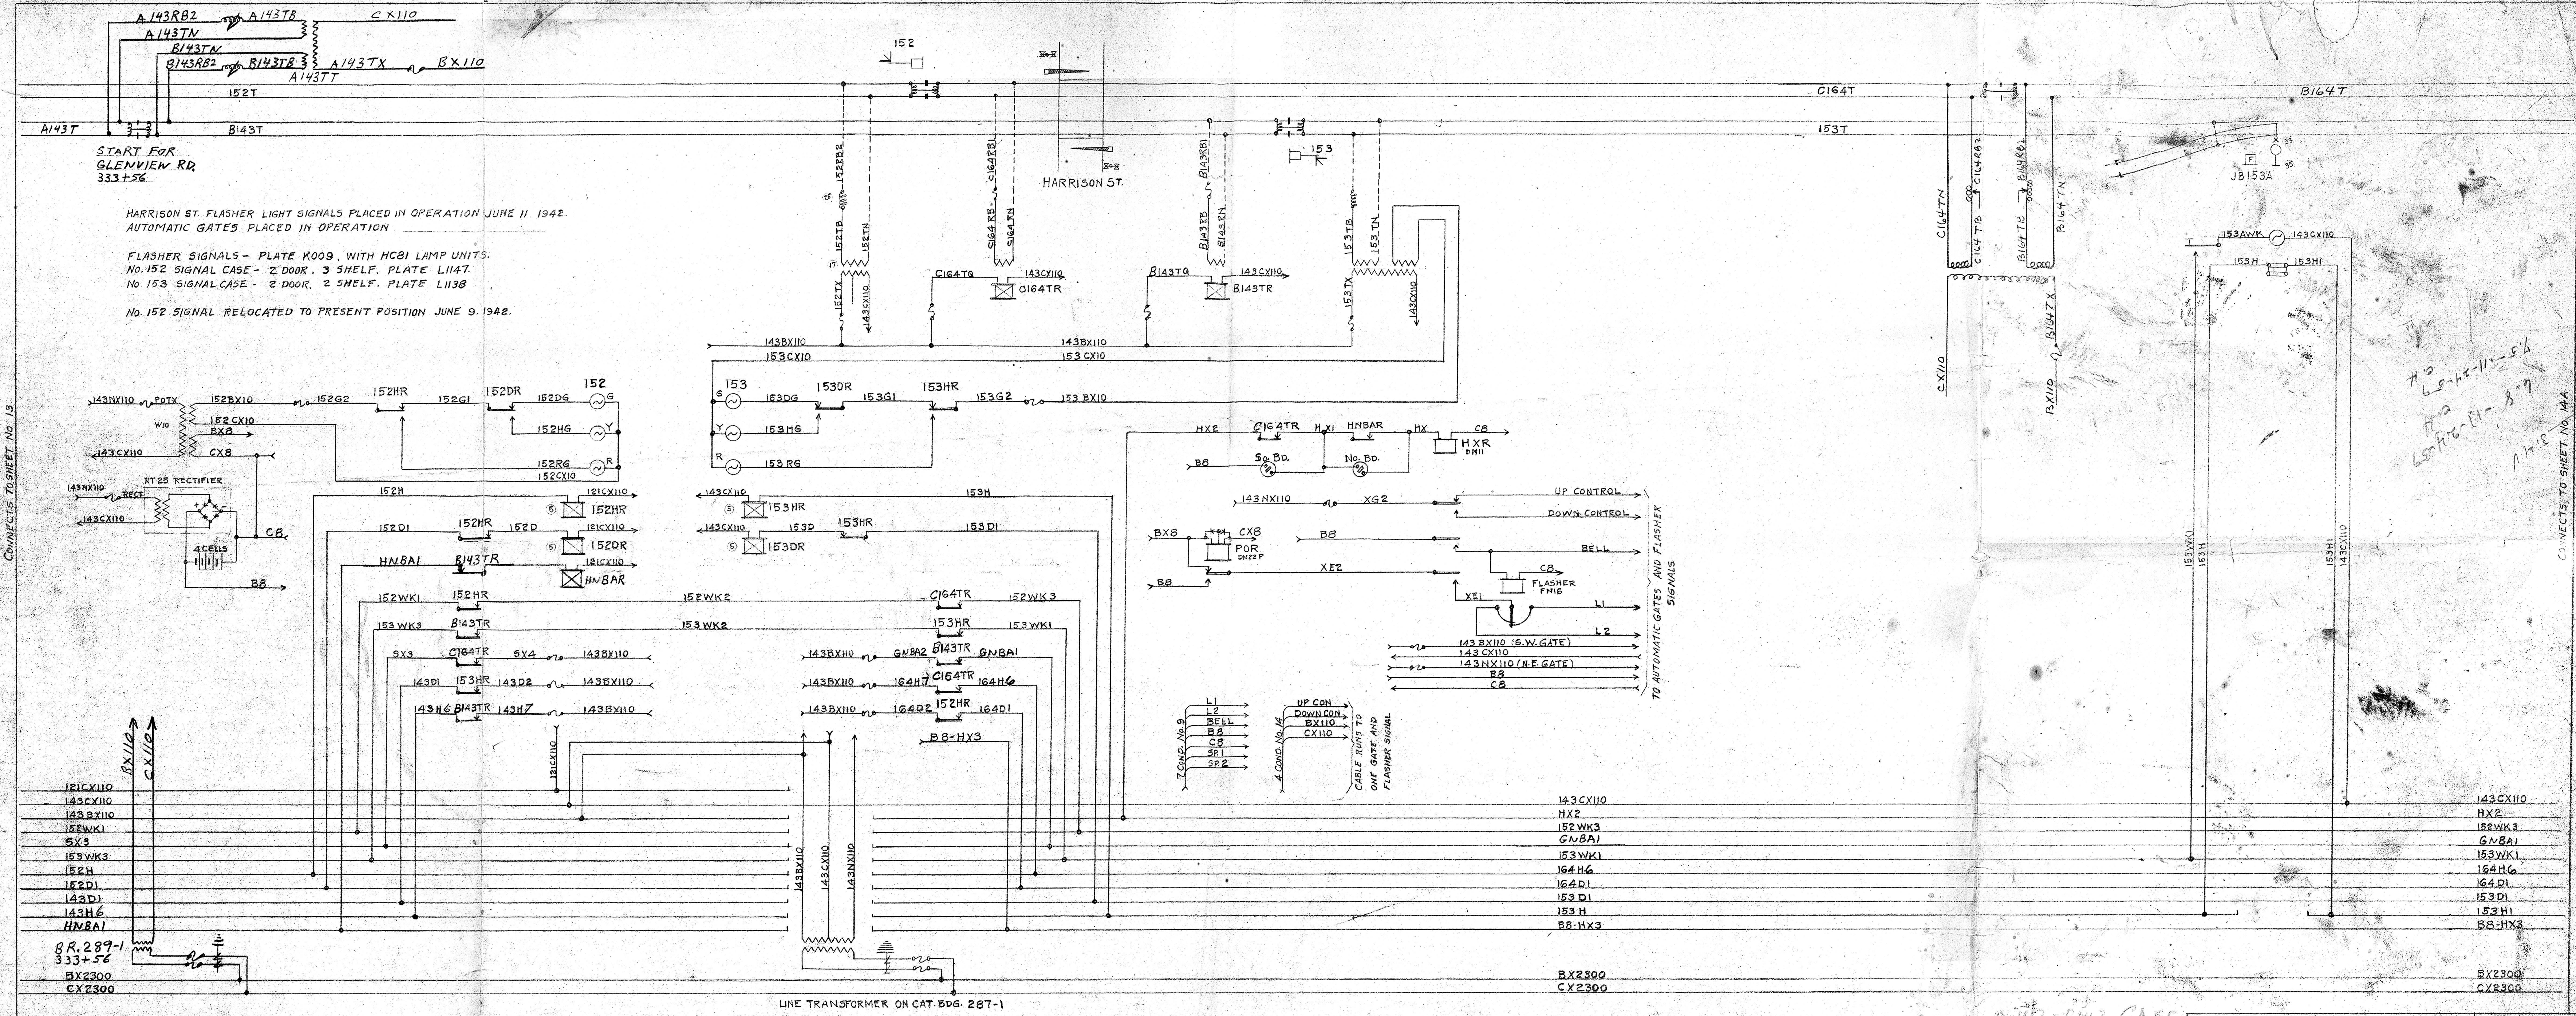

START FOR
GLENVIEW RD.
333+56

HARRISON ST. FLASHER LIGHT SIGNALS PLACED IN OPERATION JUNE 11 1942.
AUTOMATIC GATES PLACED IN OPERATION

FLASHER SIGNALS - PLATE K009, WITH HC81 LAMP UNITS.
No. 152 SIGNAL CASE - 2 DOOR, 3 SHELF, PLATE L1147.
No. 153 SIGNAL CASE - 2 DOOR, 2 SHELF, PLATE L1138.
No. 152 SIGNAL RELOCATED TO PRESENT POSITION JUNE 9, 1942.

HARRISON ST.

JB153A

7 COND. NO. 9
L1
L2
BELL
B8
C8
SP1
SP2

4 COND. NO. 14
UP CON
DOWN CON
BX110
CX110

CABLE RUNS TO
ONE GATE AND
FLASHER SIGNAL

TO AUTOMATIC GATES AND FLASHER SIGNALS

REVISIONS	
1	7-10-39
REVISED AS INSTALLED WAM EMA PVW	
2	3-29-43
REVISED FOR HARRISON ST. AUTOMATIC GATES EG	
3	4-7-55
LAKE AVE. CROSS OVER CIRCUITS RNP	
REVISE CIRCUITS FOR SIMPSON ST. RNP 6-11-57	

CONNECTS TO SHEET NO. 14A

C. N. S. & M. R. R. (SKOKIE VALLEY DIV.)
HOWARD ST. TO NORTH CHICAGO JCT.
CIRCUITS FOR AUTOMATIC SIGNALING

31 SHEETS	SHEET NO. 14
DATE 7-29-37	E 5367
NO SCALE	