Notes:
Machine to be for vertical leadout,
To have 16 way locking bed and
Lever 27325. All levers to be pipe connected and to have 8¾", 9¾" and 10¾" stroke front only. Levers 2 & 5 to be equipped with circuit controller, 39900.

STAPLES MINN. ~~41014~~ 310.3 C

DOG CHART CONT. 1698-C

NORTHERN PACIFIC RY.

GENERAL RAILWAY SIGNAL CO ROCHESTER N.Y.

MARCH. 1-1913.
Revised as installed July 28, 1914-B
Rev. Electric Lock was not shown on 6 " 1-22-19

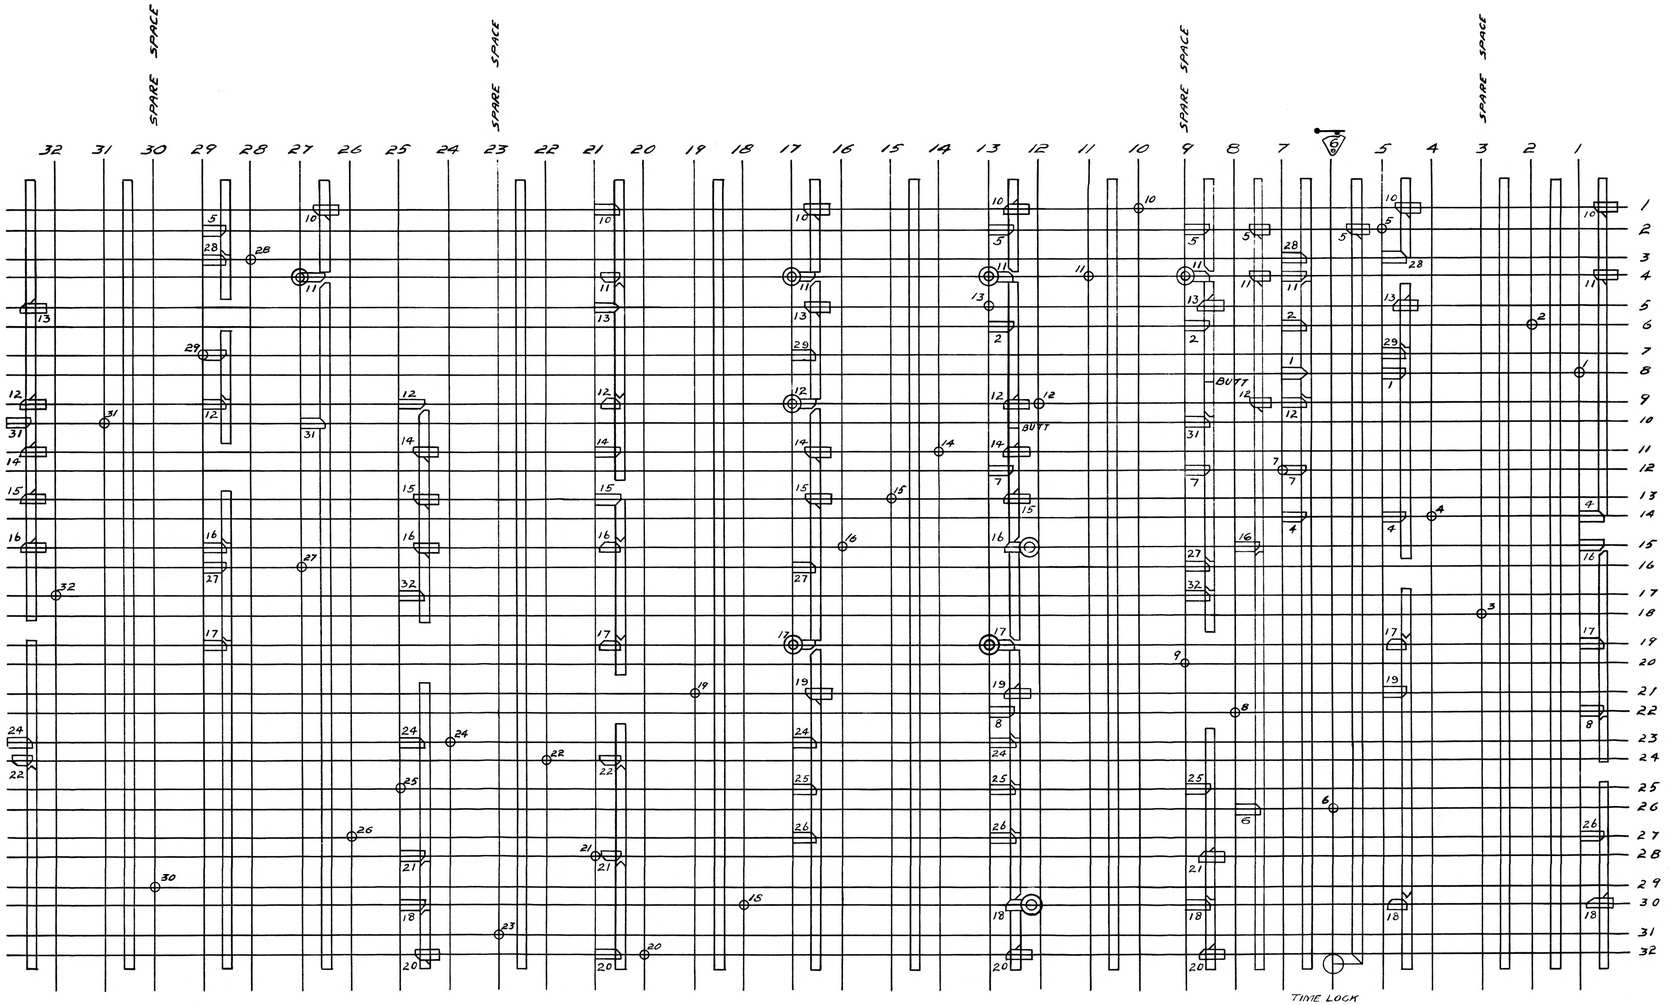

LOCKING SHEET

Lever	Locks	Lever	Locks
1	11 12 (13) 29	18	
2	11 (12) (13) (14) (15) 31 27	19	17 (17) 18 (18)
	(19) 24 25 26 W 16 (17)		
	(20) W 16 (17) 18	20	21 (21) 22 (22)
3	Spare Space	21	
4	(10) (11) 12 (13) 29	22	
5	(10) 28	23	Spare Space
	(12) (13) (14) (15) 31 27 W (11)		
	(19) 24 25 26 W (11) 16 (17)	24	18 21 (20) (19) 22 (22)
	(20) W (11) 16 (17) 18		(15) (14) W (17)
			(13) W (17) (12)
6	(5) (11) (12) 16		(10) W (17) (12) (11)
		25	(21) (20) (19) 18
7	12 (14) (15) 32 27		(15) (14) W (17)
	(19) 24 25 26 W 16 (17)		(13) W (17) (12)
	(20) W 16 (17) 18		(10) W (17) (12) (11)
8	17 (19) 24 25 26	26	(18) (19)
	(20) W 18		(15) (14) W (17)
			(13) W (17) (12)
9	Spare Space		(10) W (17) (12) (11)
10	11 (11)	27	16 17 (15) (14)
			(13) W (12)
11			(10) W (12) (11)
12		28	11 (10)
13	11 (11) 12 (12)	29	12 (13)
			(10) W (11)
14	12 (12)	30	Spare Space
15	16 (16) 17 (17)	31	(12) (13) (14) (15) (16)
			(10) W (11)
16		32	(16) (15) (14) 12
17	16		

DRAWN BY W.H.W.
TRACED BY R.W.B.
CHECED BY

W.H. Workman
APPROVED

W. K. Howard
FOR G.R.S.CO
APPROVED

FOR R.R.CO.